


CO: MCLeod County	TWP: 117-N	Buried Plant Staking Sheet & Record	Sheet 1 OF 1
SEC: 17	Range: 30-W		
Staked By: AF	Date: May 30 2017	Company: Nu-Telecom	Job#
As Built By:	Date:	Wersal 23457 230 th Ave	SO#:

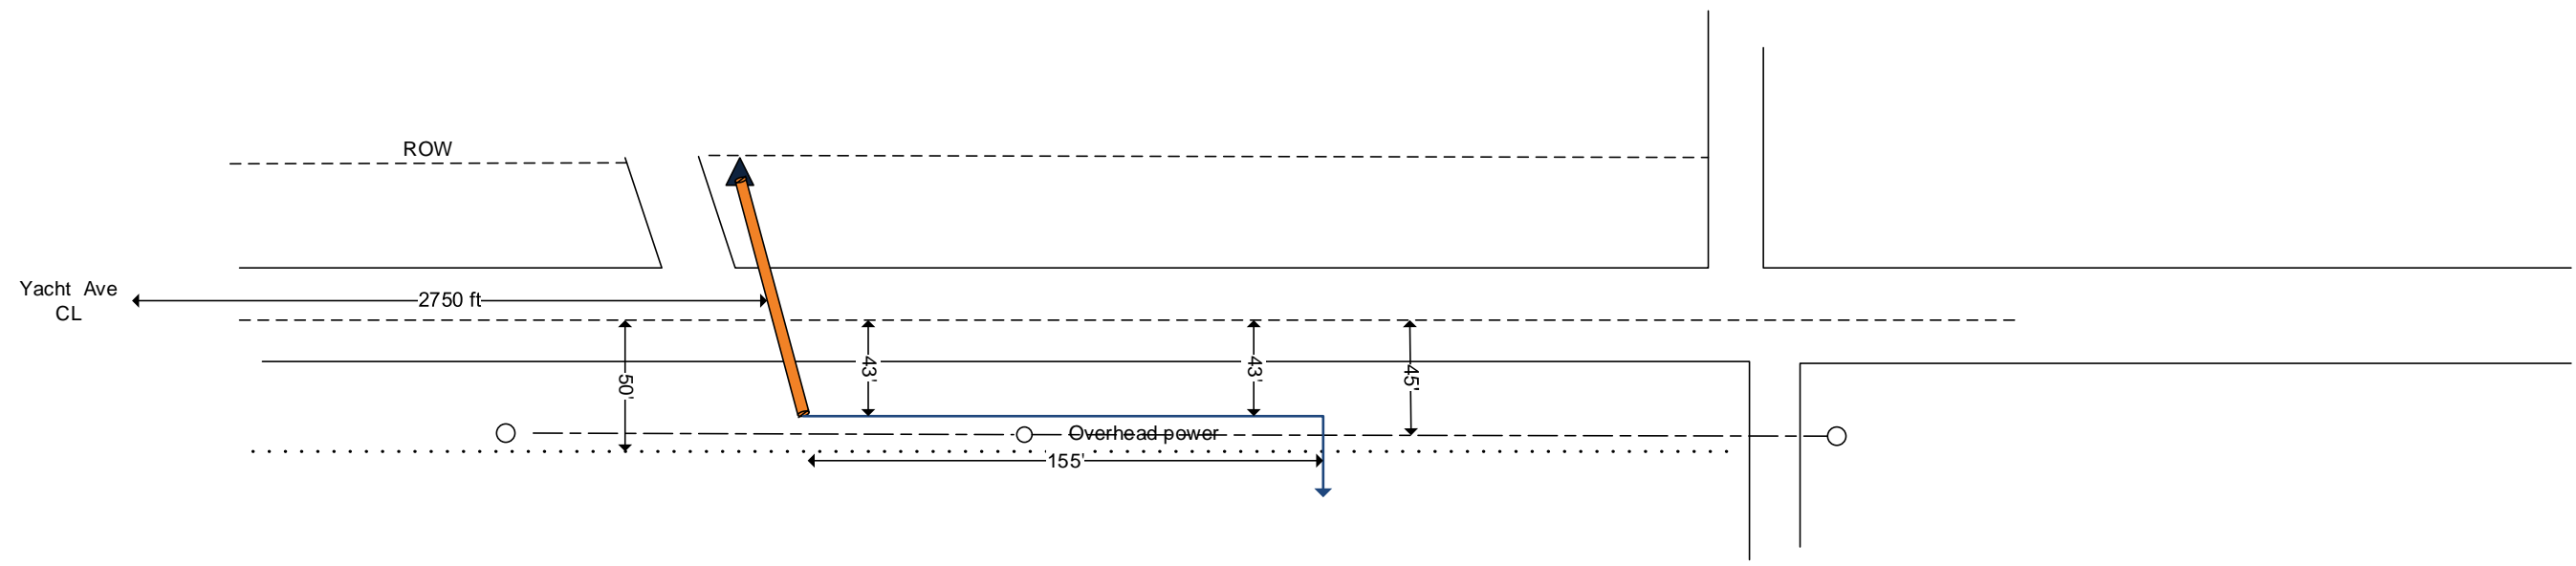

23457
230th Ave